


ONE FINANCIAL CENTER

enlightenedcommerce

8th Floor

19,202 SF AVAILABLE | AS-BUILT PLAN

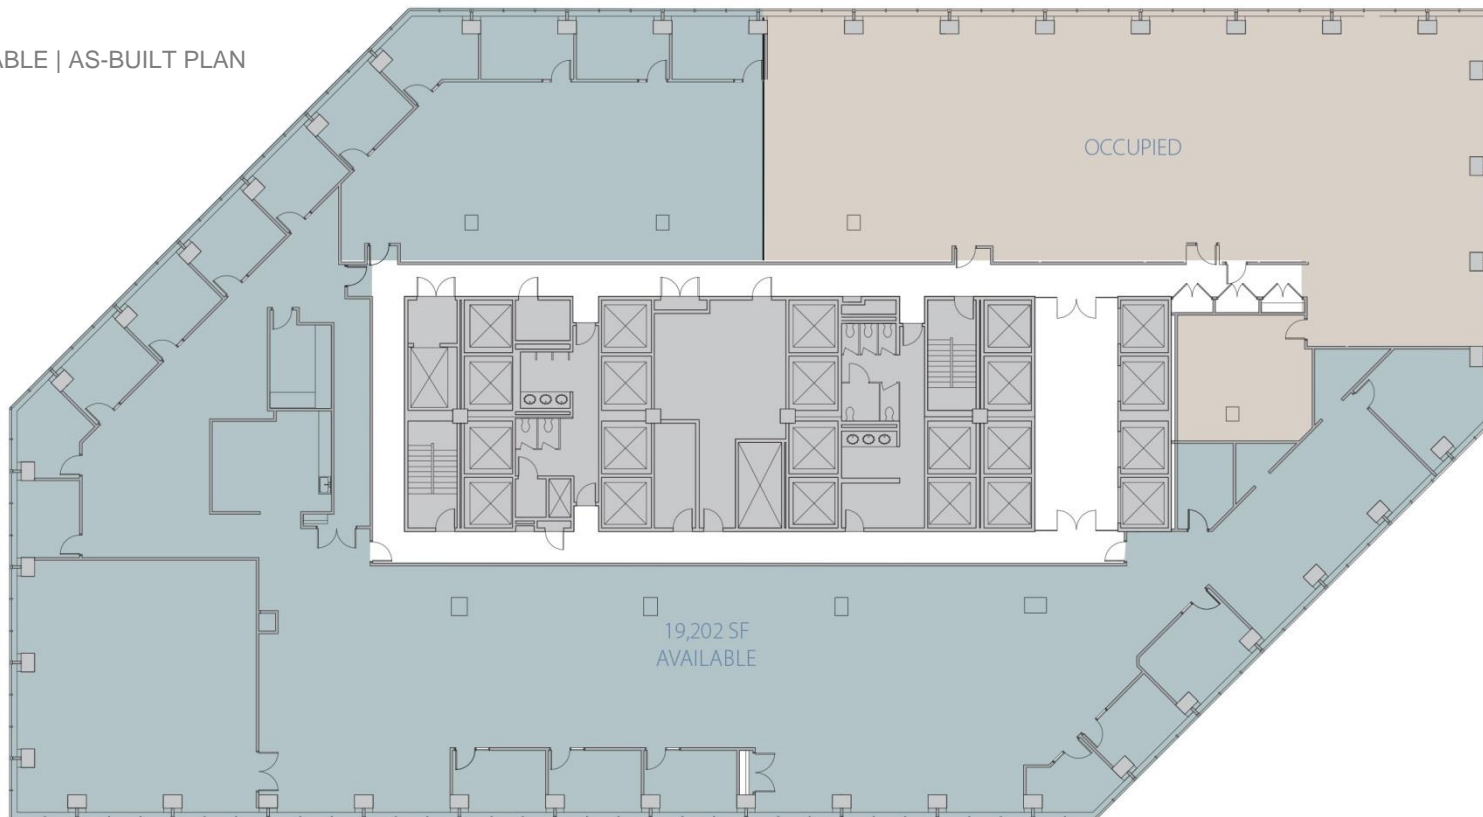

Bill Anderson 617.863.8595 wanderson@ngkf.com
Dave Martel 617.863.8525 dmartel@ngkf.com
Ali Cavanaugh 617.863.8541 acavanaugh@ngkf.com

**Newmark Grubb
Knight Frank**



Procuring broker shall only be entitled to a commission, calculated in accordance with the rates approved by our principal only if such procuring broker executes a brokerage agreement acceptable to us and our principal and the conditions as set forth in the brokerage agreement are fully and unconditionally satisfied. Although all information furnished regarding property for sale, rental, or financing is from sources deemed reliable, such information has not been verified and no express representation is made nor is any to be implied as to the accuracy thereof and it is submitted subject to errors, omissions, change of price, rental or other conditions, prior sale, lease or financing, or withdrawal without notice and to any special conditions imposed by our principal.